OWNERS CERTIFICATE

I/We hereby certify that I am/we are the owner(s) of the property shown hereon as evidenced in Book 7074, page 493, R.O.D.C., Tennessee, and adopt the plan as shown hereon and dedicate all public ways and easements as noted.

HAURY & SMITH CONTRACTORS, INC.

By: _____

Date: 12/30/91

SURVEYORS CERTIFICATE

To the best of my knowledge and belief I certify that this is a plat of the condominium apartments known as "RIVER PLANTATION" located in the Second Civil District of Metropolitan Nashville and Davidson County, Tennessee, situated on land described in the deed to Reese Smith, Jr. from River Plantation, as recorded in Book 7074, page 493, R.O.D.C., Tennessee, and that said plat truly represents each apartment in the building, its apartment number, its location in the building and the approximate number of square feet in each apartment.

This plat is filed pursuant to Section 64-2707 of Tennessee Code Annotated.

RAGAN - SMITH - ASSOCIATES, INC.

BY: _____

Date: December 12, 1991

GEORGE E. DANIELS REGISTERED LAND SURVEYOR XVI AGRICULTURE COMMERCE TENNESSEE NO. 737

COMMISSION APPROVAL

Approved for record in the Register's Office of Davidson County, not a subdivision, but a plat of apartments in a horizontal property regime for reference in transferring title to the apartments.

By: _____

Date: 4/1/92

RECORD

RECORDED 4/2/92 IN BOOK 7900, PAGE 365, OF THE REGISTERS OFFICE OF DAVIDSON COUNTY, TENNESSEE.

SUBDIVISION NUMBER

9/87/P 91S-278G

GENERAL NOTES


1. THIS SURVEY MEETS THE REQUIREMENTS OF A SUBURBAN LAND SURVEY AS PER CHAPTER 0820-3 OF THE STANDARDS OF PRACTICE AS ADOPTED BY THE BOARD OF EXAMINERS FOR LAND SURVEYORS FOR THE STATE OF TENNESSE, DATED SEPT. 29, 1980.
2. ALL DISTANCES SHOWN BASED ON A FIELD RUN SURVEY USING E.D.M. EQUIPMENT AND ARE ADJUSTED FOR TEMPERATURE.
3. PARCEL NUMBERS SHOWN THUS (00) PERTAIN TO PROPERTY MAP
4. THE REQUIREMENTS OF ORDINANCE 84-142 WILL APPLY TO THE RECORDING OF THIS SUBDIVISION PLAT.
5. ANY EXCAVATION, FILL OR DISTURBANCE OF THE EXISTING GROUND ELEVATION MUST BE DONE IN ACCORDANCE WITH STORM WATER MANAGEMENT ORDINANCE NO. 78-840 AND APPROVED BY THE METROPOLITAN DEPARTMENT OF PUBLIC WORKS.
6. BEARINGS BASED ON RIVER PLANTATION SECTION VIII, PHASE II.
7. PROPERTY ZONED R-15 (LOW-MEDIUM DENSITY RESIDENTIAL) DISTRICT WITH P.U.D. OVERLAY.
8. THIS PROPERTY IS NOT WITHIN AN AREA OF FLOOD INUNDATION AS DESIGNATED BY CURRENT FEDERAL EMERGENCY MANAGEMENT AGENCY MAPS WHICH MAKE UP A PART OF THE NATIONAL FLOOD INSURANCE ADMINISTRATION REPORT COMMUNITY PANEL NO. 470040-0254 DATED JUNE 15, 1982.
9. UTILITIES ARE LOCATED BY FIELD OBSERVATION AND INFORMATION SUPPLIED TO US BY PHONE CONVERSATIONS WITH THE UTILITY AGENCIES. VERIFICATION OF EXISTANCE, LOCATION AND DEPTH SHOULD BE MADE BEFORE ANY DECISION RELATIVE THERETO IS MADE. AVAILABILITY OF SERVICE SHOULD BE CONFIRMED WITH THE APPROPRIATE UTILITY COMPANY.
10. THIS PLAT IS BEING RECORDED AS PART OF A PLANNED UNIT DEVELOPMENT OVERLAY DISTRICT ENACTED BY ZONING ORDINANCE 87-1628.
11. MASTER DEED RECORDED IN BOOK 8061, PAGE 341, R.O.D.C., TN AND AMENDED IN BOOK 8391, PAGE 251, R.O.D.C., TN.


R-15 (P.U.D.)

RAGAN-SMITH-ASSOCIATES, INC.
CIVIL ENGINEERING—SURVEYING—LANDSCAPE ARCHITECTURE
315 WOODLAND STREET
NASHVILLE, TENNESSEE 37206
(615) 244-8591

MINIMUM BUILDING SETBACK LINES SHALL BE DETERMINED BY METROPOLITAN ZONING REGULATIONS.

TOTAL BOUNDARY = 179,389 ± SQ. FT. OR 4.118 ± AC.

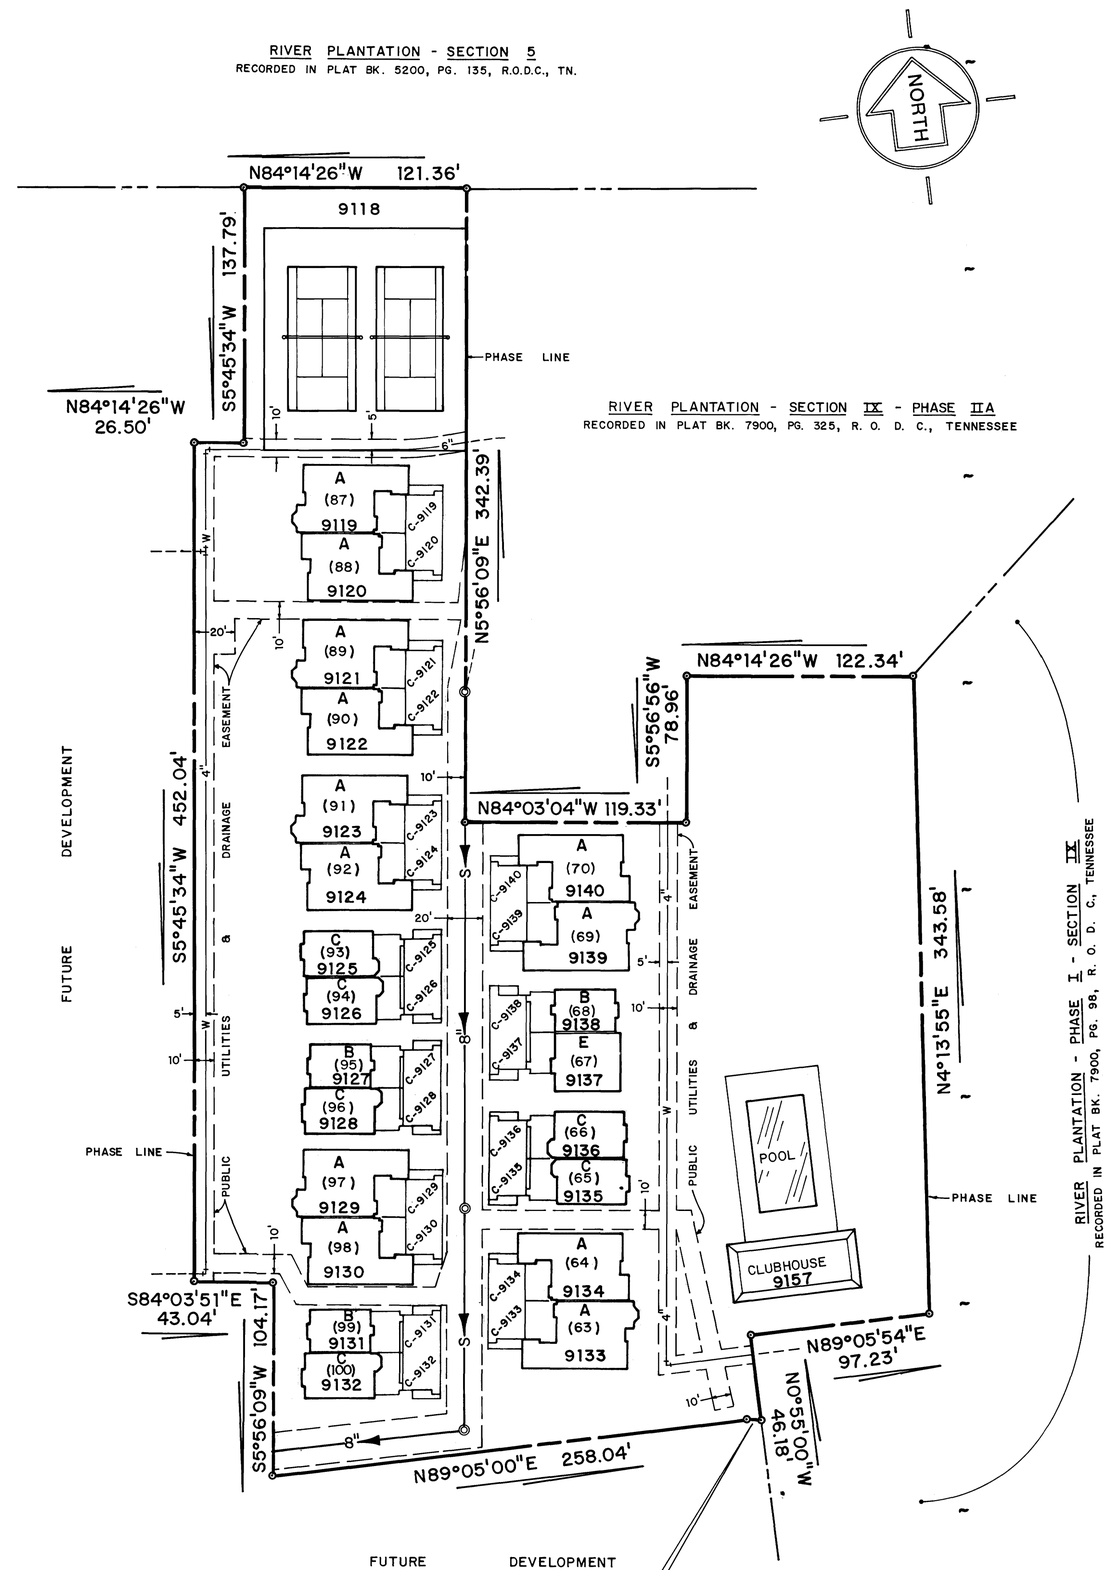

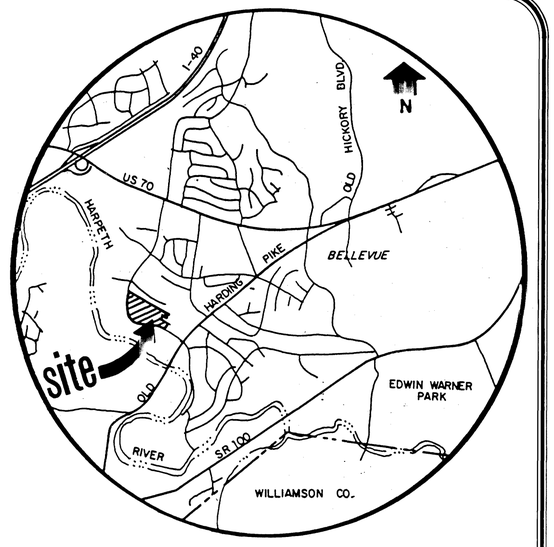

LOCATION MAP

(NOT TO SCALE)

LEGEND

EXISTING FIRE HYDRANT
EXISTING GAS LINE — 6"-G—
EXISTING PUBLIC UTILITIES AND DRAINAGE EASEMENT
EXISTING SANITARY SEWER LINE — 8"
EXISTING WATER LINE — 6"-W—
FIRE HYDRANT
PROPERTY LINE
PUBLIC UTILITIES AND DRAINAGE EASEMENT
RIGHT-OF-WAY LINE
SANITARY SEWER LINE — 8"
SANITARY SEWER MANHOLE
WATER LINE — 6"-W—

EXISTING CONCRETE MONUMENT (O)
EXISTING IRON ROD (O)
EXISTING PLANTED STONE (O)
CONCRETE MONUMENT SET (N)
IRON ROD SET (N)

C-00 — CARPORT
A — UNIT TYPE
(00) — PROPERTY TAX-MAP PARCEL
000 — UNIT POSTAL NUMBER

SPECIAL NOTE:

THE AREA OUTSIDE OF THE BUILDING LIMITS IS OPEN COMMON AREA & PUBLIC UTILITIES & DRAINAGE EASEMENT

UNIT SCHEDULE

UNIT TYPE	SQUARE FEET IN UNIT
"A"	2,000
"B"	1,500
"C"	~ 1,900
"E"	2,100

TOTAL NUMBER OF UNITS = 22

CONDOMINIUM APARTMENTS

FINAL PLAT

RIVER PLANTATION

SECTION IX - PHASE IIB

2nd Civil District Metropolitan Nashville Davidson Co. Tennessee

REESE SMITH, JR. OWNER

35th COUNCILMANIC DISTRICT - MR. CHARLIE TYGARD, COUNCILMAN

50 25 0 50 100 150

SCALE: 1" = 50'

A.C. HOUSE

DATE: ~~DEC. 26th, 1991~~ ~~JAN. 8th, 1992~~ FEB. 13th, 1992

JOB 86-176
W.O. 2413